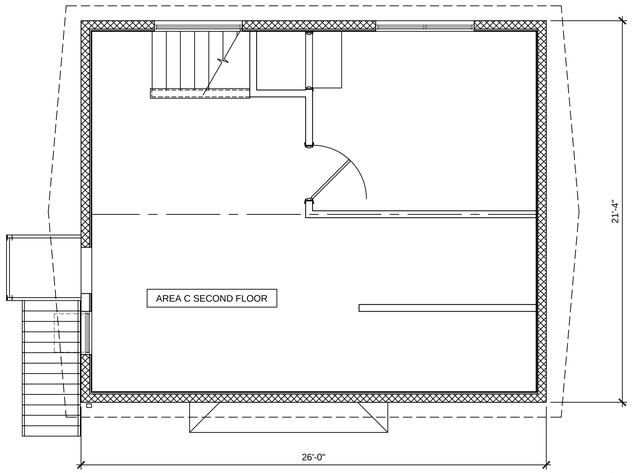

2 SECOND FLOOR PLAN - EXISTING CONDITIONS

SCALE: 1/4" = 1'-0"

PLAN NORTH

AREA INFORMATION	
	NET RENTABLE AREA
AREA A	1.667 SF
AREA B	1.674 SF
AREA C FIRST FLOOR	457 SF
AREA C SECOND FLOOR	468 SF
RESTROOMS	279 SF
ENTRY VESTIBULE	24 SF
	GROSS BUILDING AREA
FIRST FLOOR	555 SF
SECOND FLOOR	4,473 SF

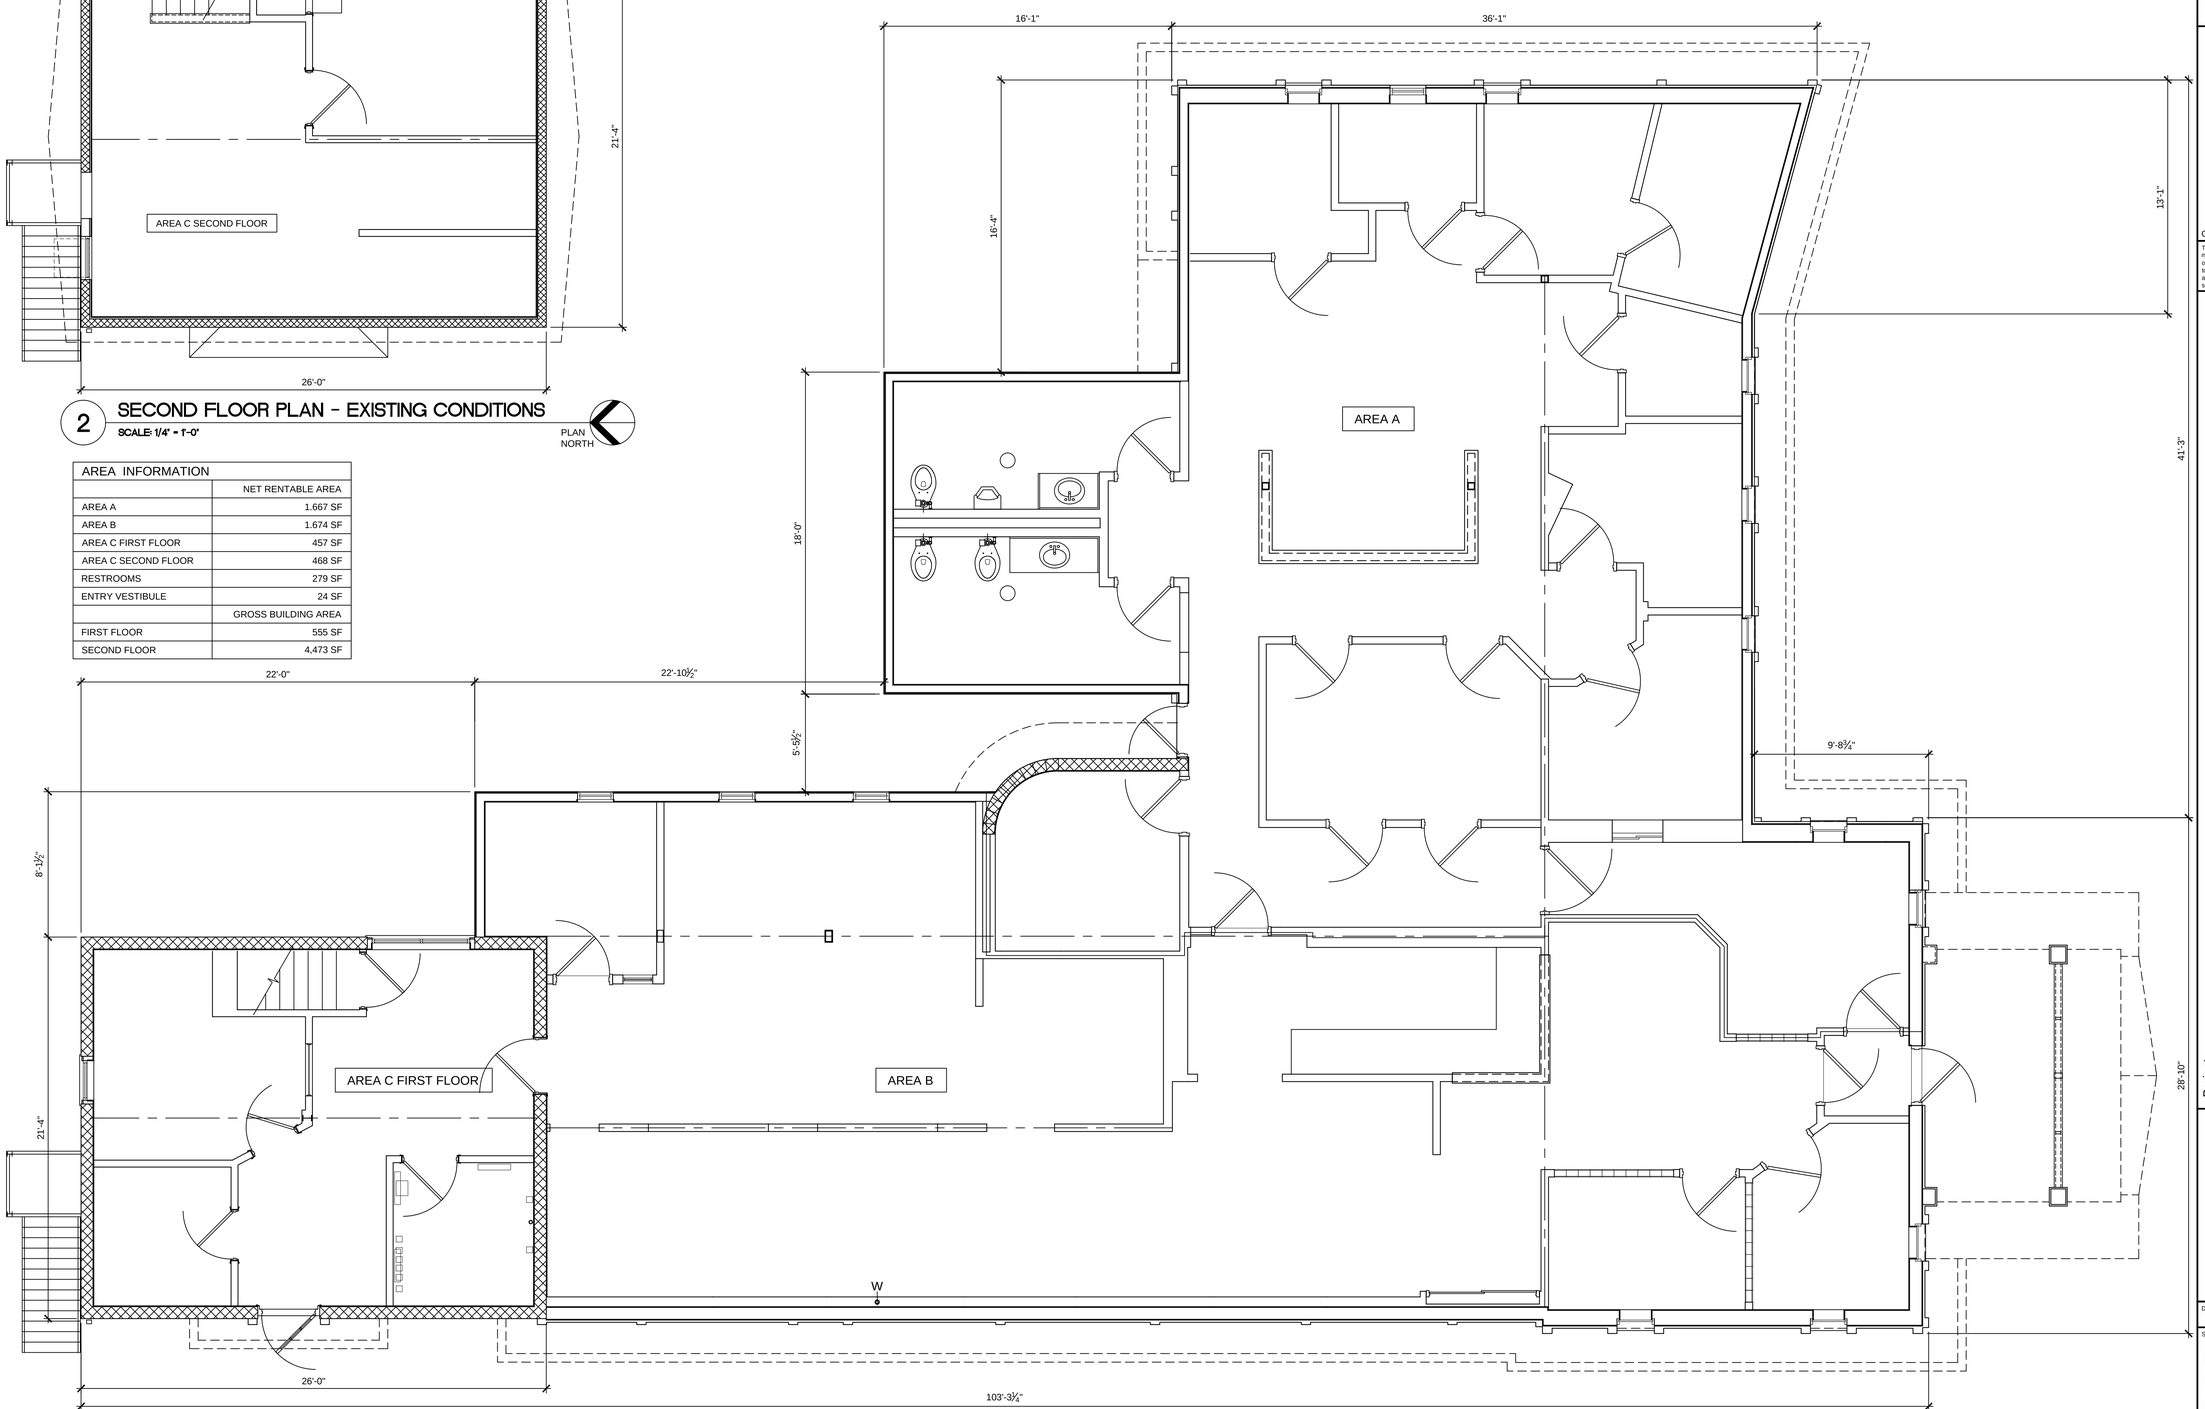

1 FIRST FLOOR PLAN - EXISTING CONDITIONS

SCALE: 1/4" = 1'-0"

PLAN NORTH

Project Team:

Architect:

ZDG

ZIPFEL DESIGN GROUP, LLC
9138 Rusticwood Trail
Crestwood, MO 63126
314-849-6861

NOT FOR CONSTRUCTION

Gregory A. Zipfel, RA Registration - MO A-007480

The Professional Architect's seal affixed to this sheet applies only to the materials and items shown on this sheet. All drawings, documents and other instruments of service not exhibiting this seal shall not be considered to be prepared by this architect. The architect expressly disclaims any and all responsibility for such drawings, documents and other instruments of service not exhibiting this seal.

Project:
AS-BUILT CONDITIONS FOR
9147 WATSON ROAD

9147 WATSON ROAD
CRESTWOOD, MISSOURI 63126

EXISTING CONDITIONS

No.	Revision Description:	Date:
-	ISSUED FOR REFERENCE	6/23/2020

Drawn by: GAZ Reviewed by: GAZ

Sheet Title:
EXISTING CONDITIONS FLOOR PLANS

Sheet Number:
AB-01